
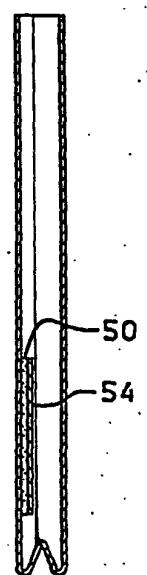
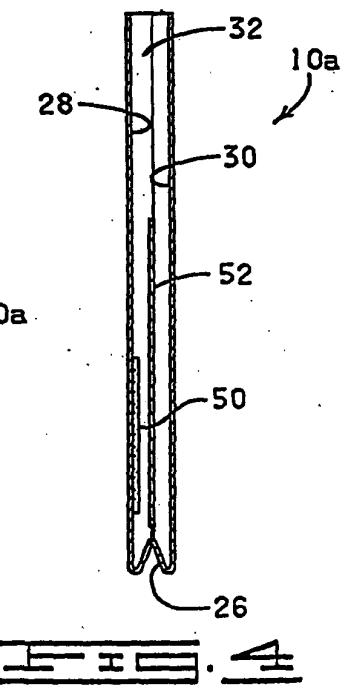
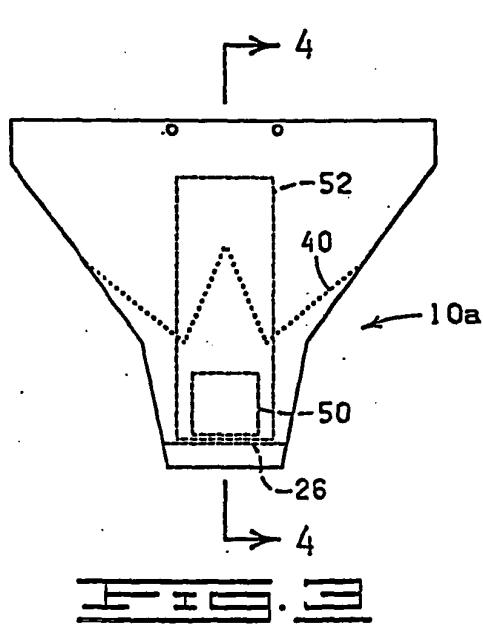
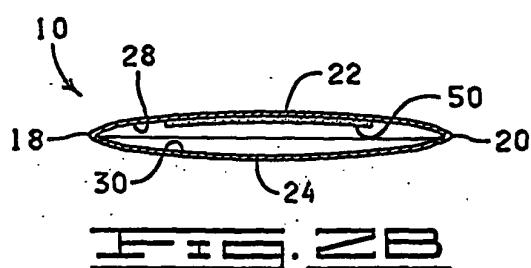
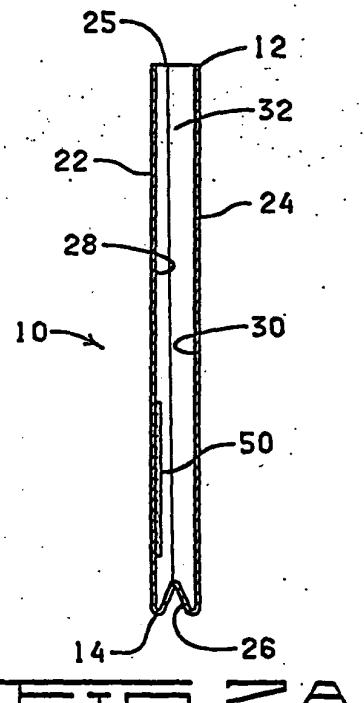



Redline Version of
Drawings: Not for
Publication

1/9


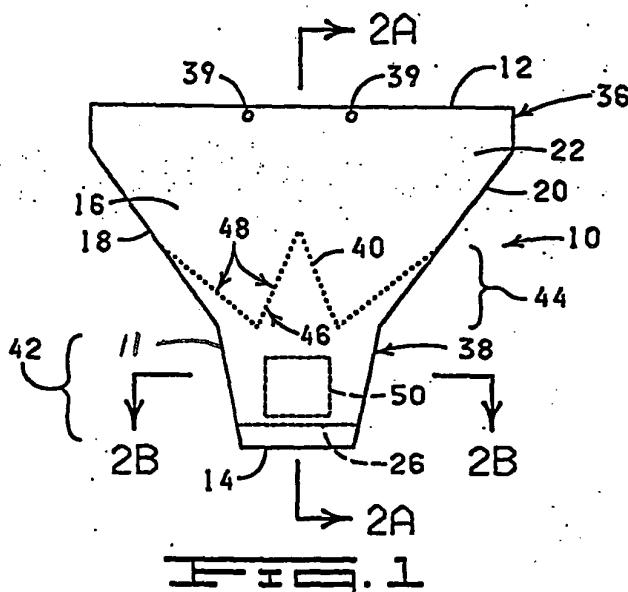


H-H-4


219

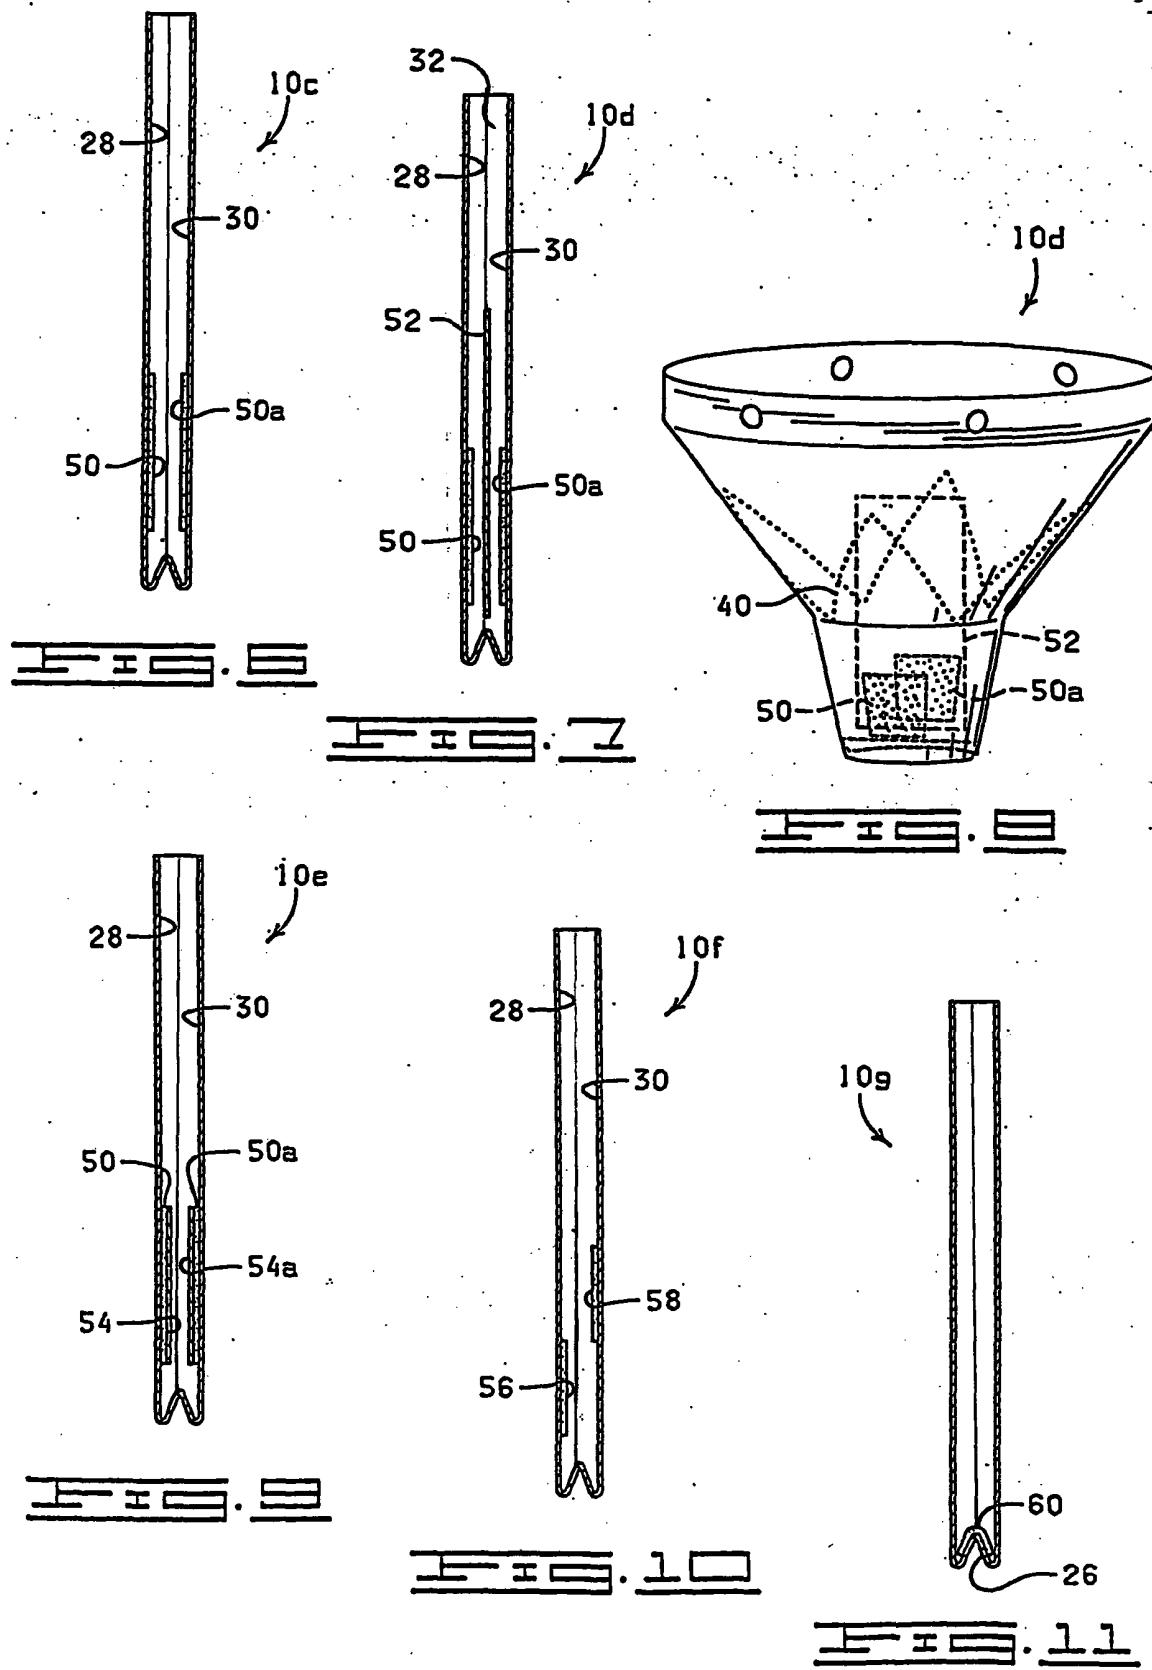


3/9

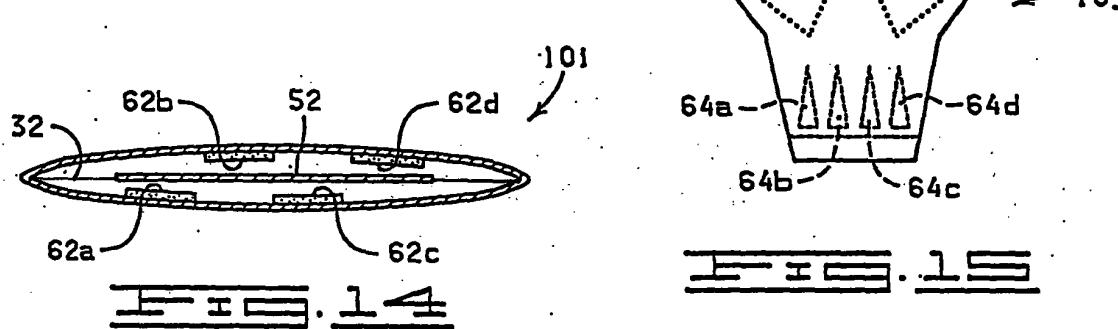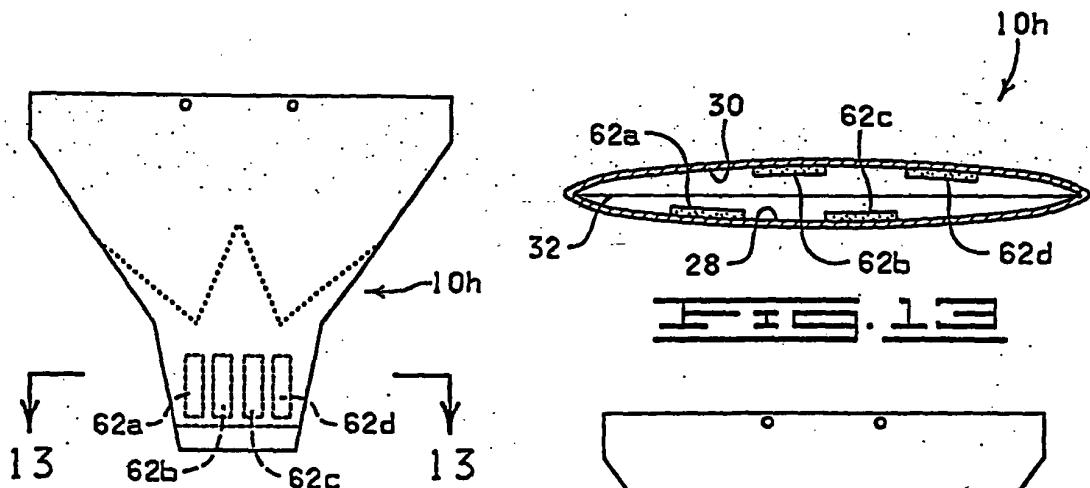

12

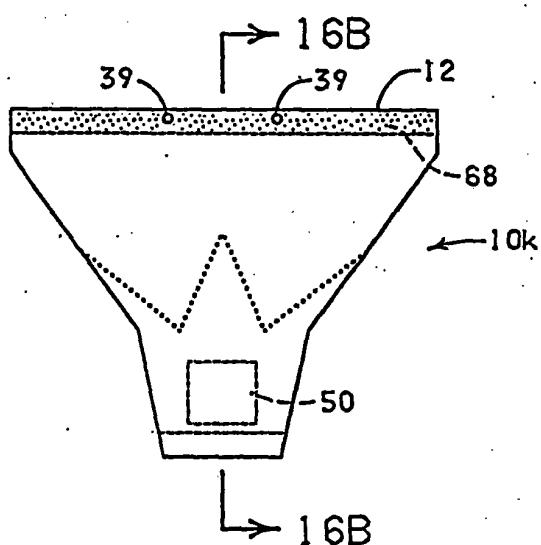


16A

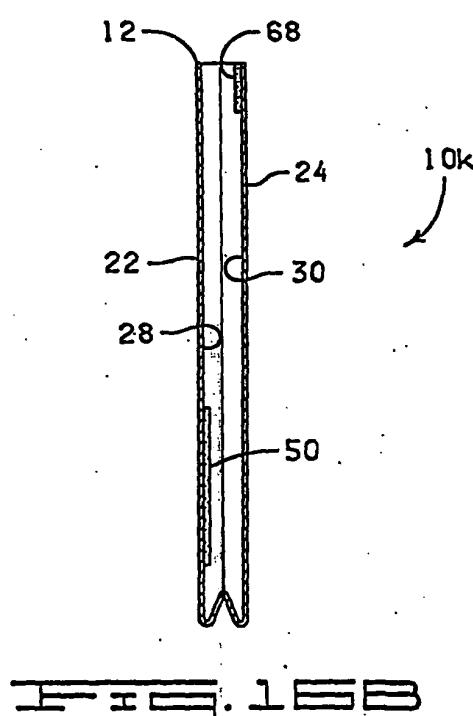


16B


4/9

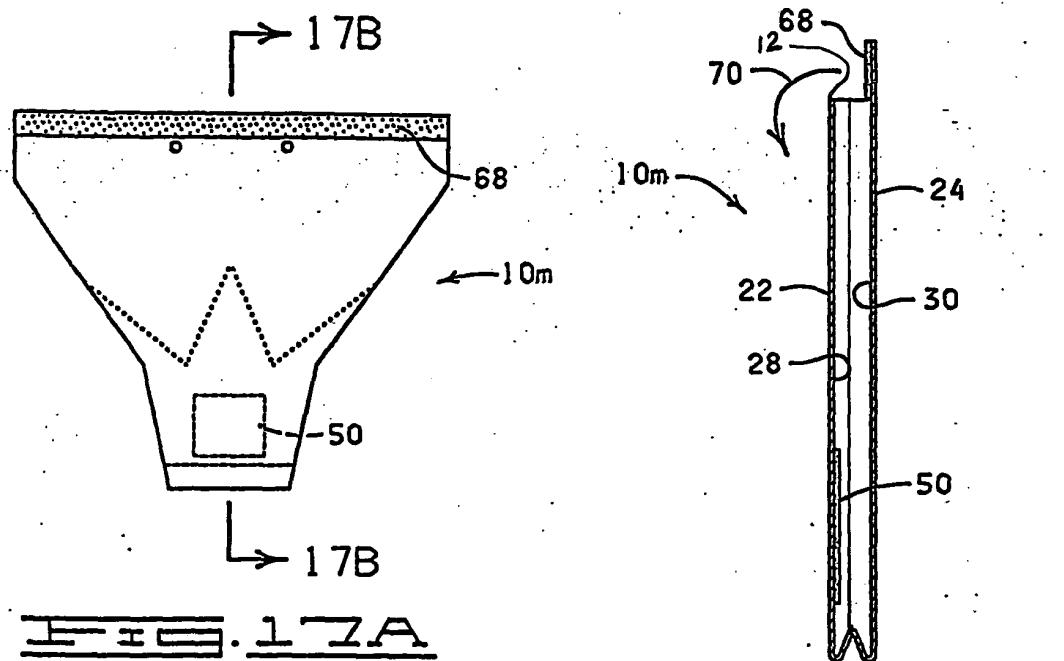


17B

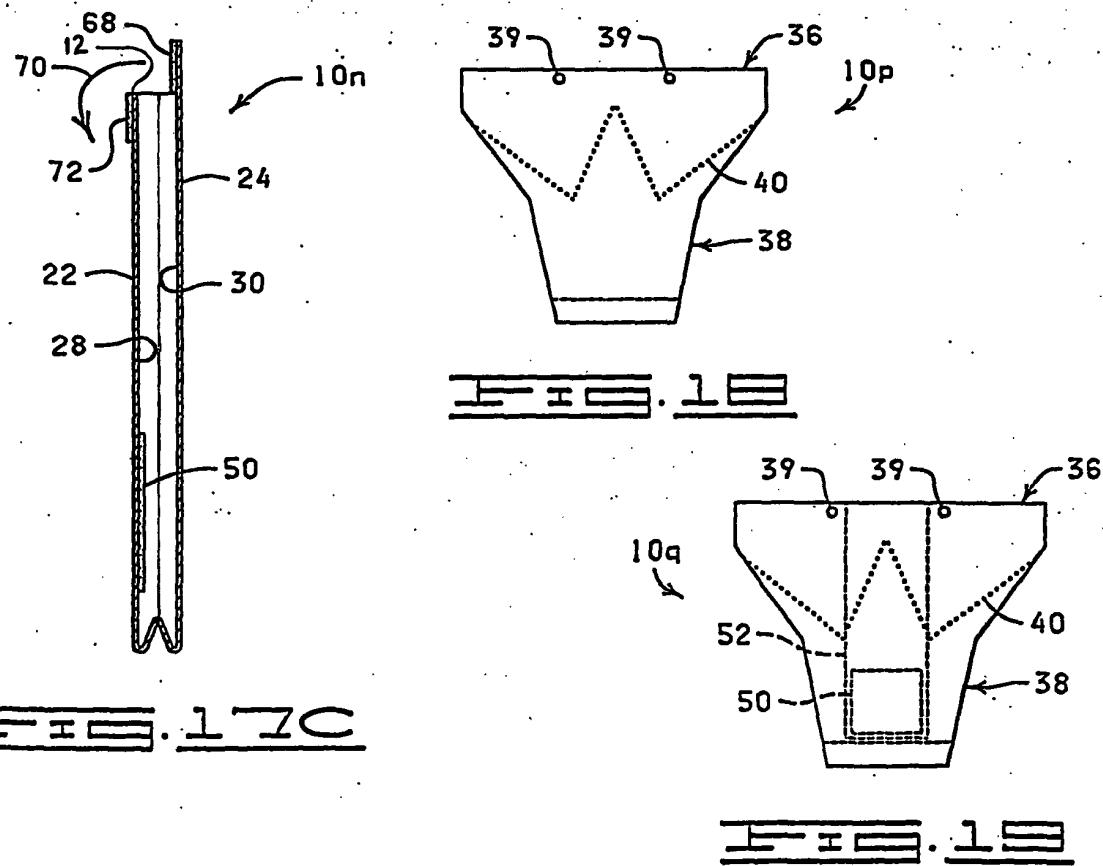

5/9


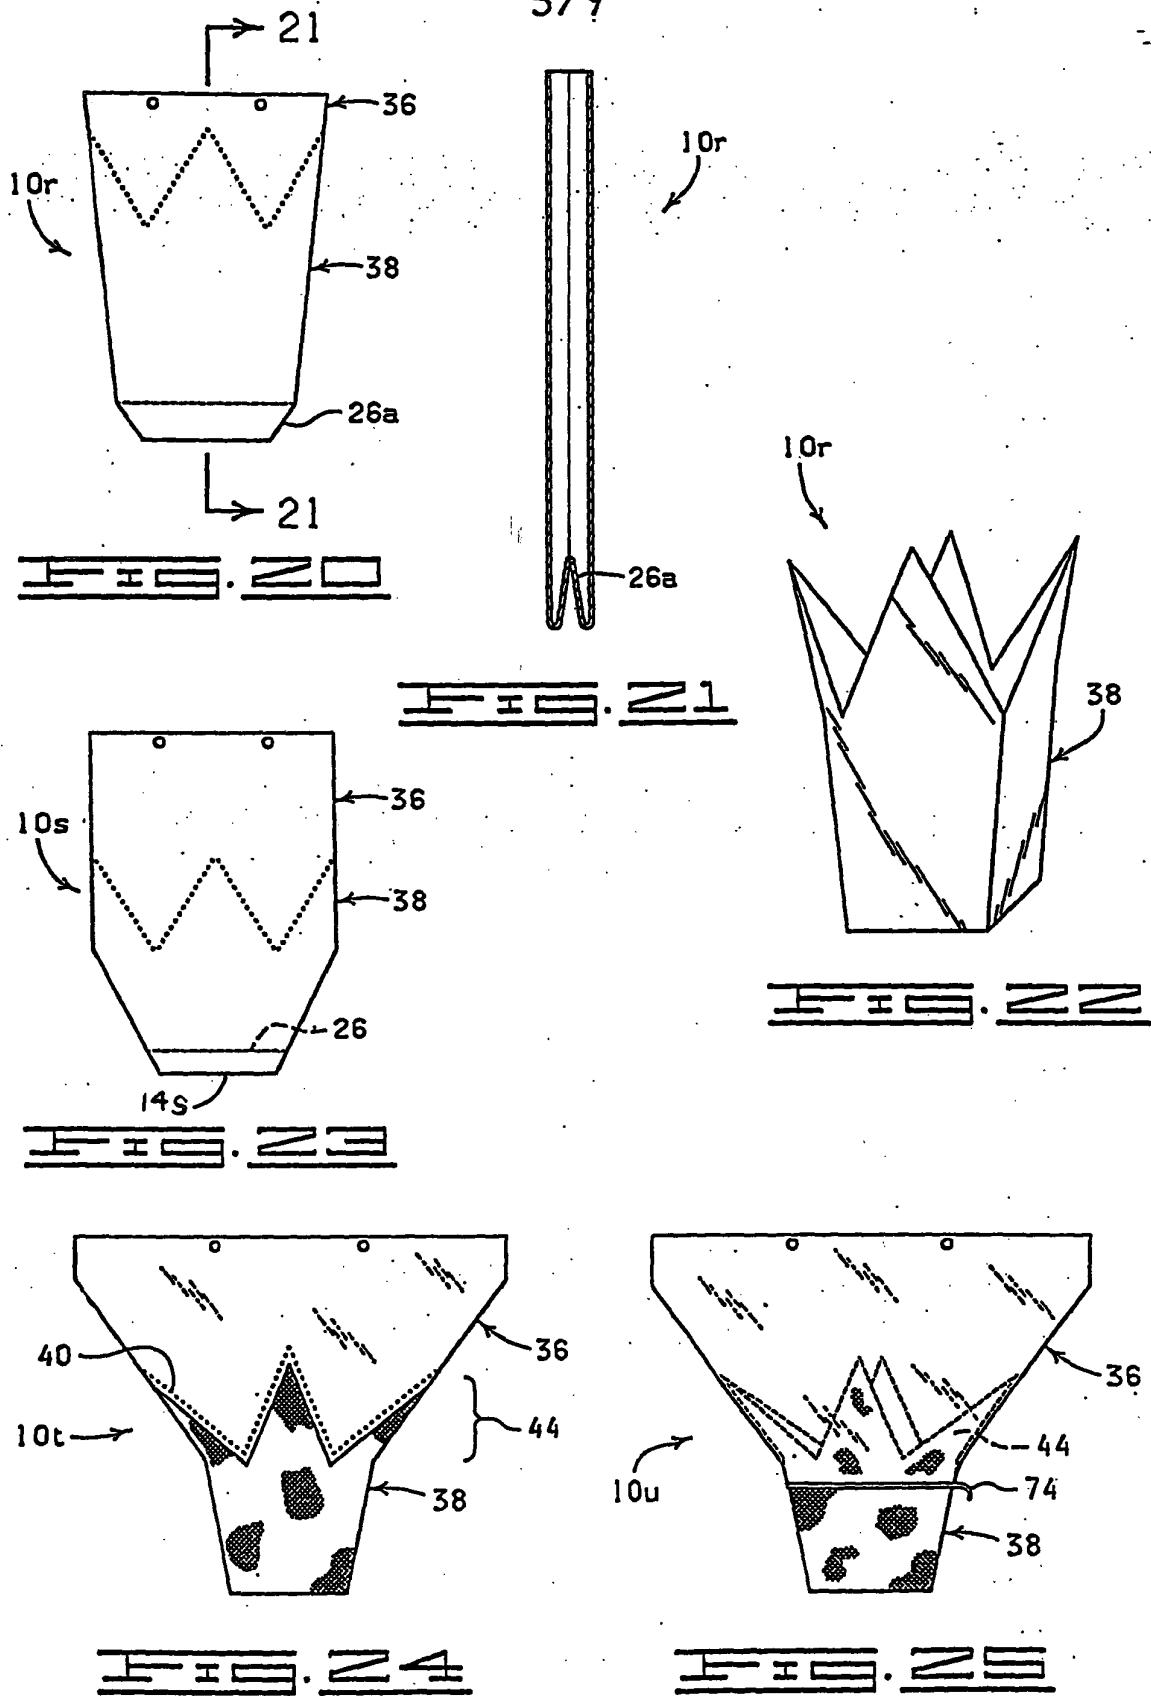


7/9

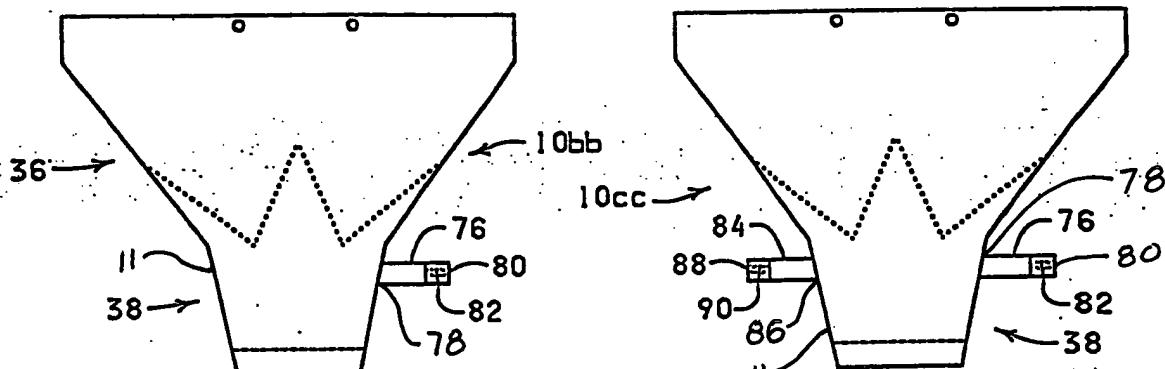



— H — . 32

— H — . 33

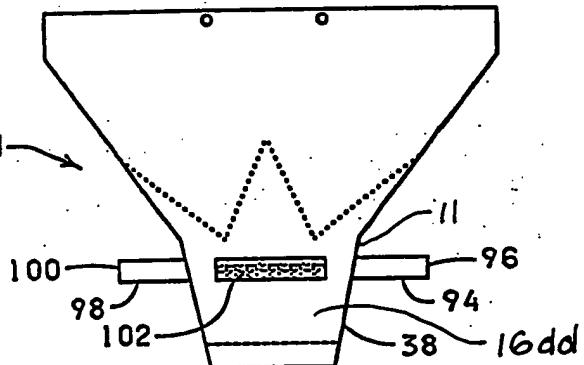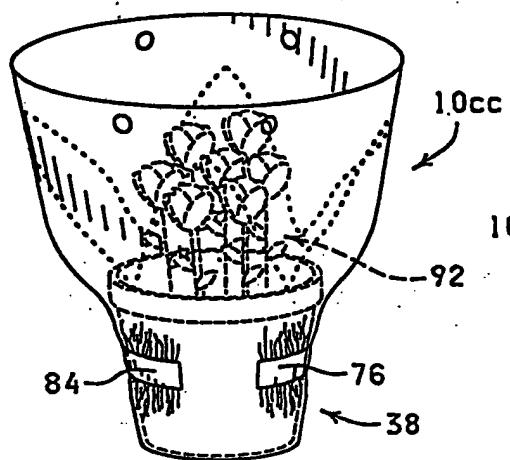

— H — . 34

— H — . 35

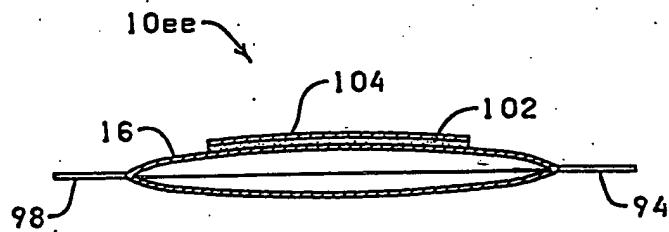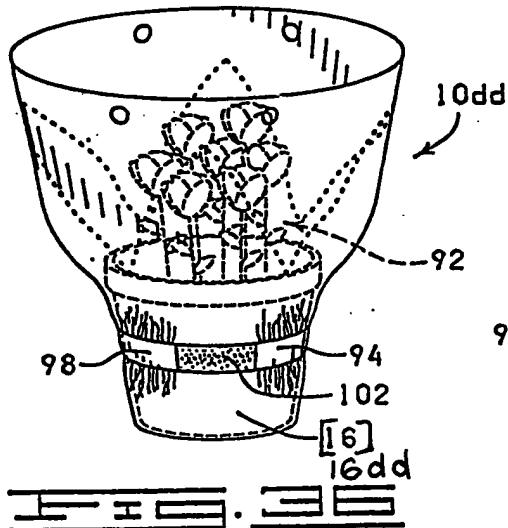

— H — . 37

8/9

